SYMBOL LEGEND:

(2) DATA, (1) VOICE RECEPTACLE
PROVIDE (3) CAT 5 CABLES TO MDF.

ALT. ALTERNATE BID:
(2) DATA, (1) VOICE FLOOR RECEPTACLE
PROVIDE (3) CAT 5 CABLES TO MDF.

(4) DATA, (2) VOICE RECEPTACLE
PROVIDE (6) CAT 5 CABLES TO MDF.

EXISTING DATA/PHONE RECEPTACLE

GENERAL NOTES:

1) EXISTING CABLE PLANT MUST BE OPERATIONAL AT ALL TIMES.

2) VERIFY EXACT LOCATIONS OF NEW OUTLETS WITH OWNER PRIOR TO INSTALLATION.

3) RACKS - FURNISHED BY OWNER INSTALLED BY CONTRACTOR.

4) TERMINATION AND TESTING BY CONTRACTOR.

5) ALL CABLING WORK SHALL BE CONCEALED.

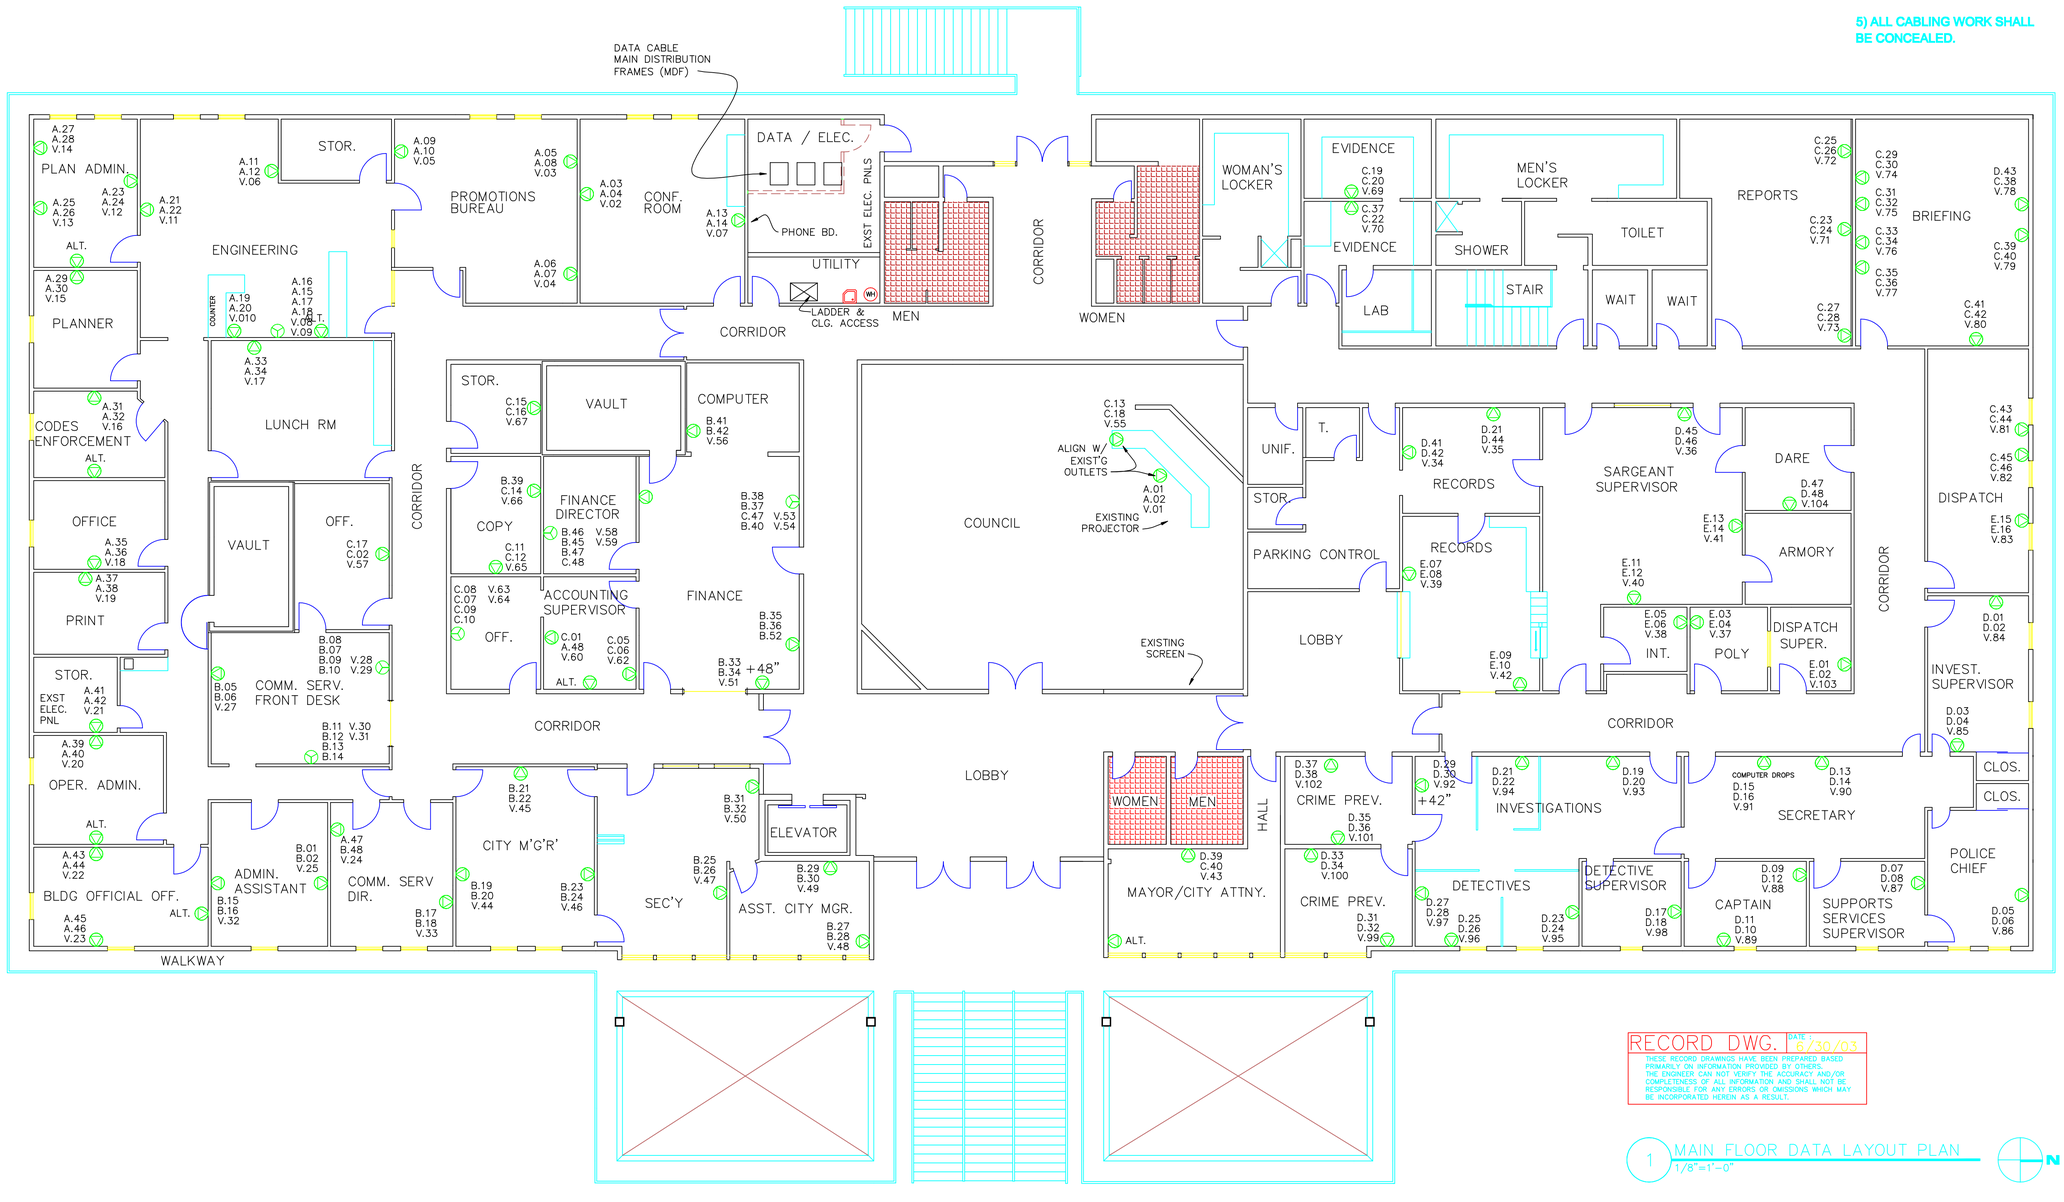

RECORD DWG. DATE: 6/30/03

THESE RECORD DRAWINGS HAVE BEEN PREPARED BASED PRIMARILY ON INFORMATION PROVIDED BY OTHERS. THE ENGINEER CAN NOT VERIFY THE ACCURACY AND/OR COMPLETENESS OF ALL INFORMATION AND SHALL NOT BE RESPONSIBLE FOR ANY ERRORS OR OMISSIONS WHICH MAY BE INCORPORATED HEREIN AS A RESULT.

1 MAIN FLOOR DATA LAYOUT PLAN
1/8"=1'-0"

N

HGE INC
ARCHITECTS, ENGINEERS, SURVEYORS, & PLANNERS
375 Park Avenue/Coos Bay, Oregon 97420 (541) 269-1166
19 N. W. Fifth Avenue/Portland, Oregon 97209 (503) 222-1611

SHEET TITLE: MAIN FLOOR DATA LAYOUT PLAN

PROJECT: COOS BAY CITY HALL 2002 COMPUTER UPGRADE

COOS BAY, OREGON

REGISTERED ARCHITECT 2840 PRELIMINARY NOT FOR CONSTRUCTION STATE OF OREGON

PROJECT NO. 02.31

DATE: 27 SEPT. 2002

REVISIONS

DATE	BY
6/30/03	E.K.

DRN BY SKS

SHEET NO. A1